
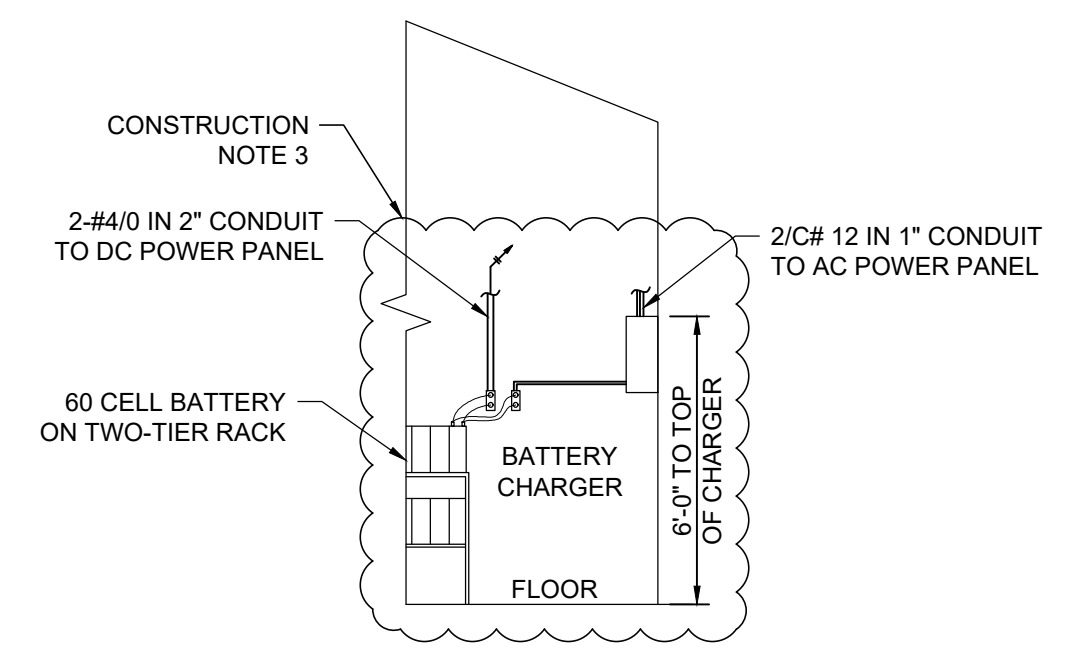
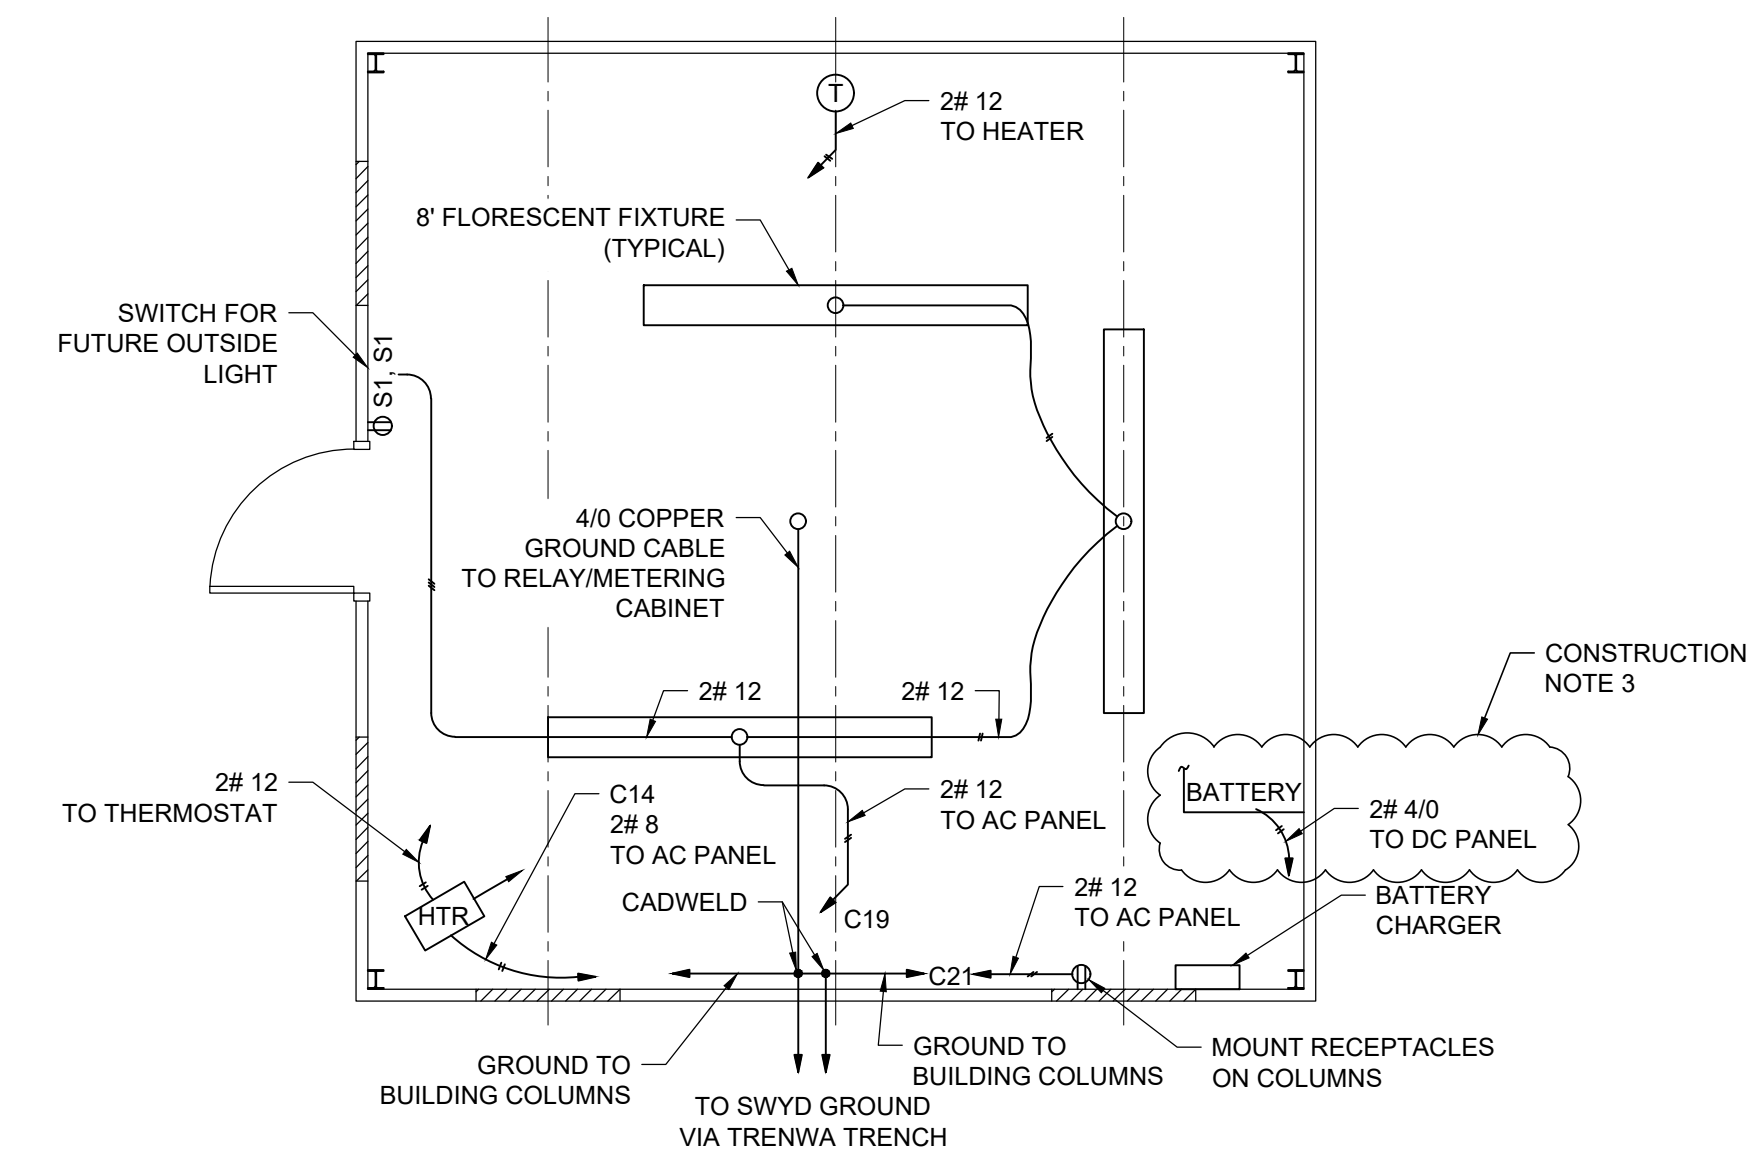
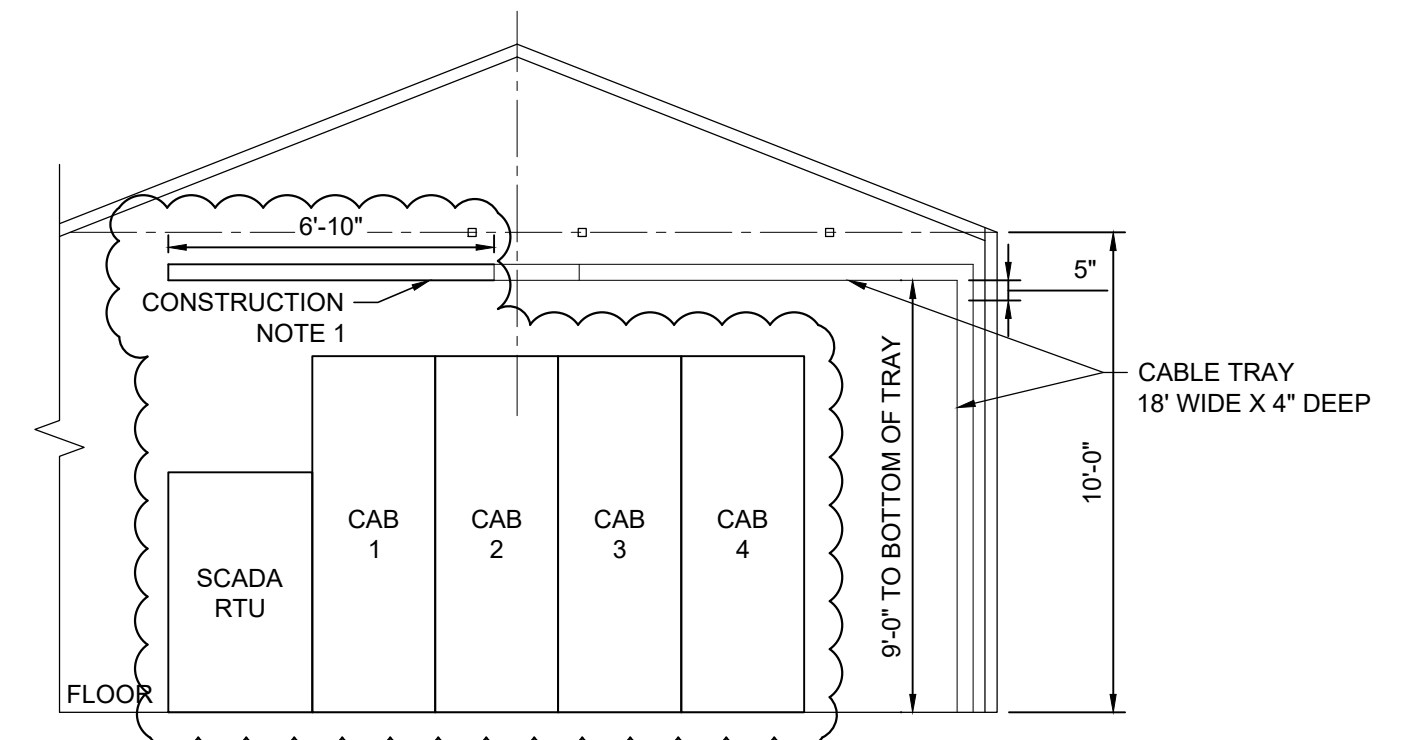
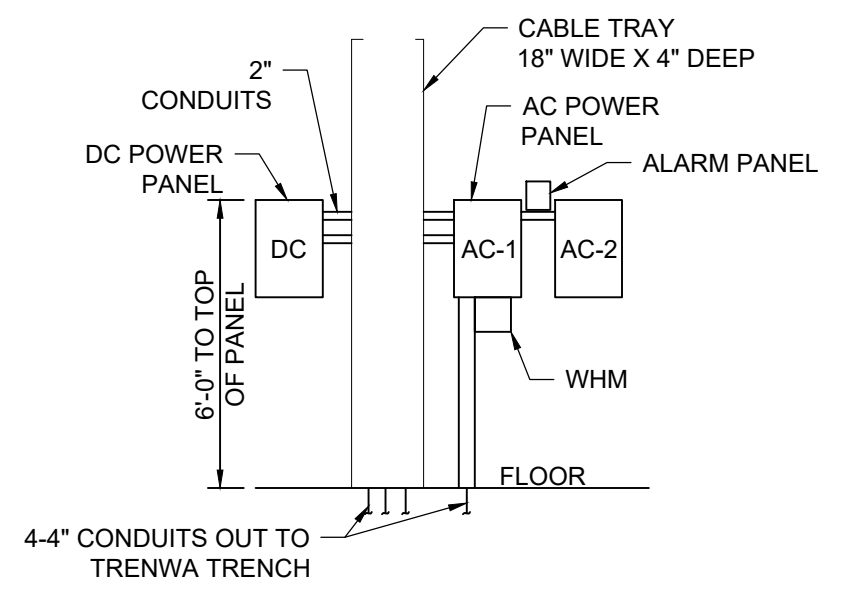




2/20/2026 8:59 AM - RYANO - N:\ACTIVE PROJECTS\63337\_IPSWITCH\ELECTRIC\_FOWLER'S LANE\_#5\_CONTROL\_HOUSE\6-DRAFTING\WORKING DRAWINGS\SUBSTATIONS\5-E-7-4.DWG

- CONSTRUCTION NOTES:**
1. CONTRACTOR SHALL BOND NEW CABLE TRAY SECTION TO EXISTING CONTROL HOUSE GROUND RING.
  2. CABLE TRAY TO BE EXTENDED TO ACCOMMODATE ADDITION OF 4 NEW CABINETS.
  3. EXACT PLACEMENT AND DIMENSIONS TO BE VERIFIED.
  4. CONTRACTOR SHALL REUSE AND RELOCATE SCADA RTU AND TURBINE SCADA RTU CABINETS.

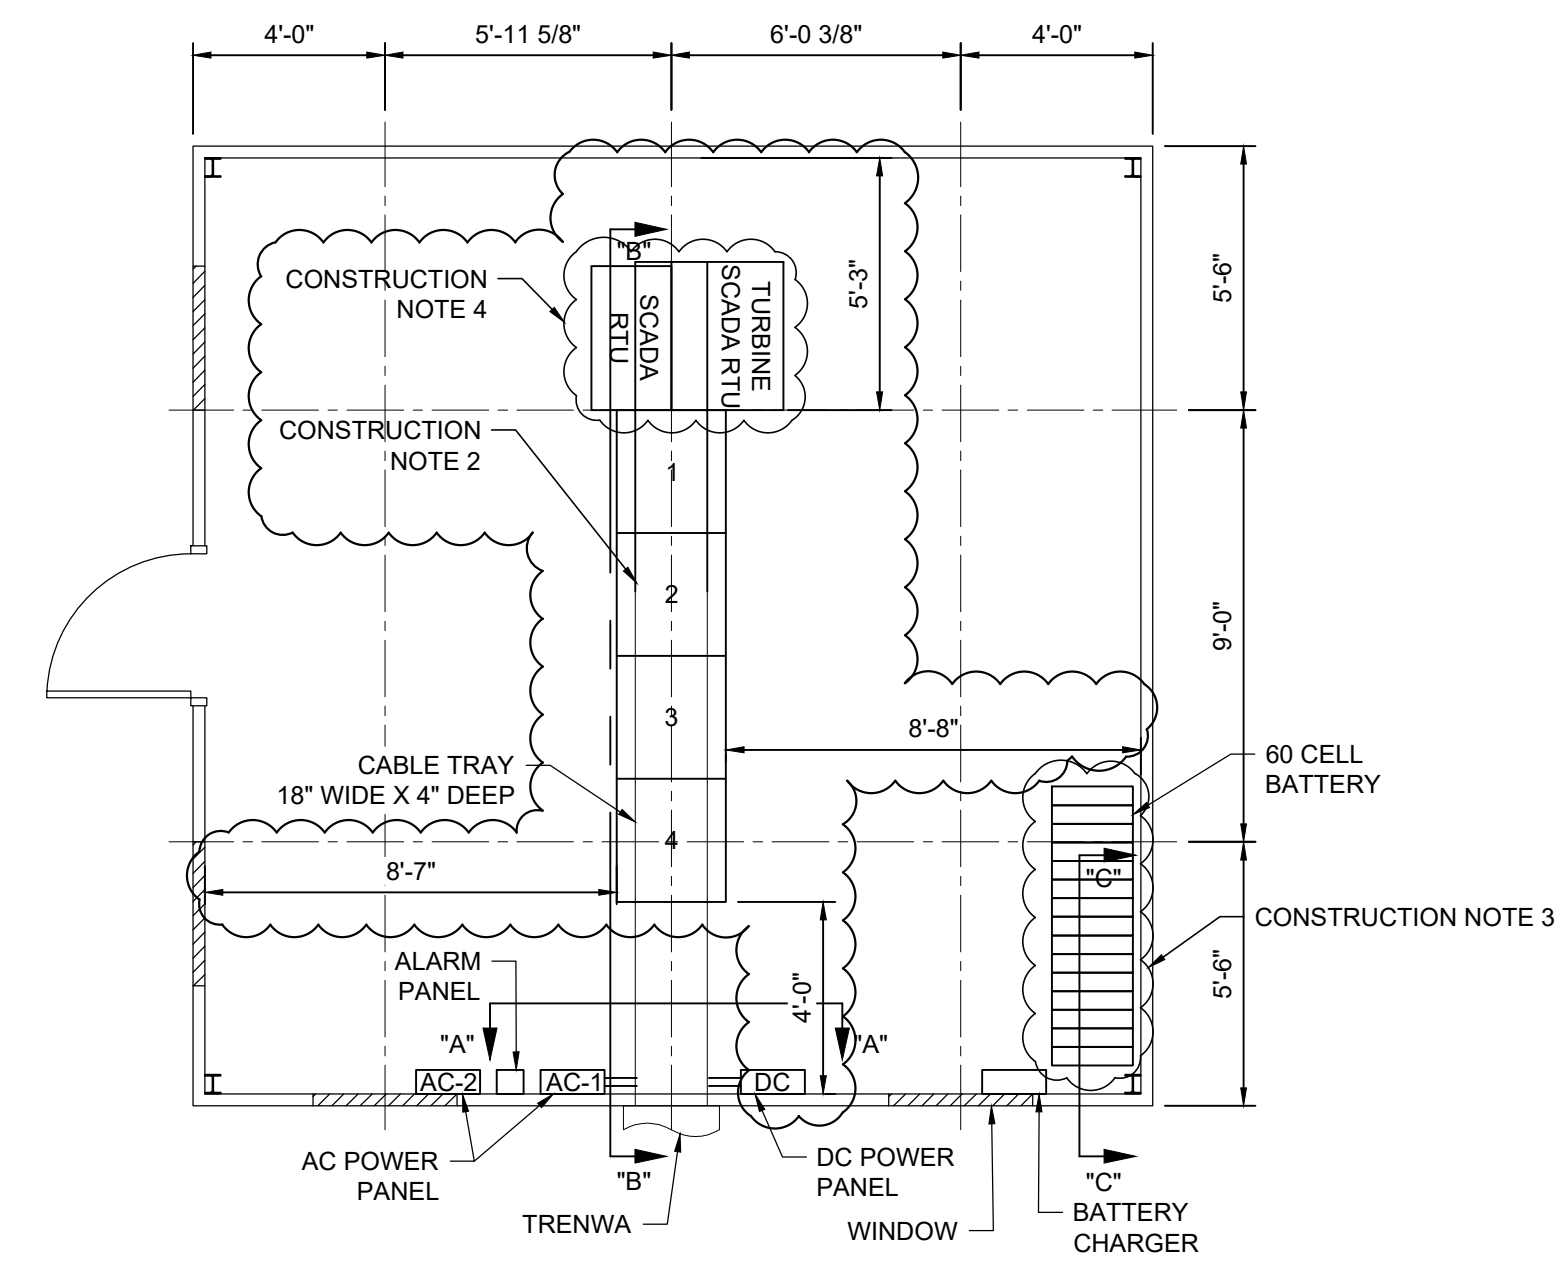

REDRAWN FROM TIF DURING 2026 CONSTRUCTION

**ADDITIONS**

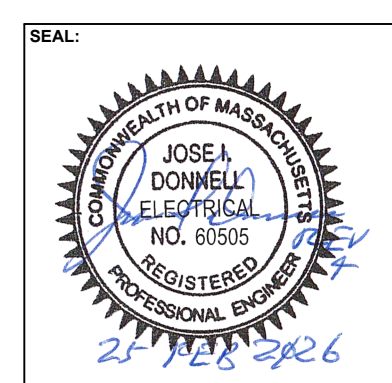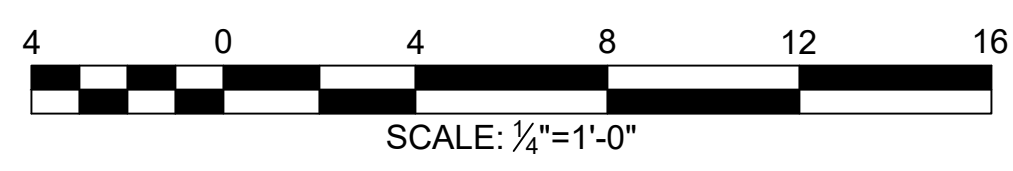

REV	DESCRIPTION	DATE	DRWN	CHKD	APRVD
4	ISSUED FOR CONSTRUCTION	02/20/26	RLC/RDO	RLC/CEH	RLC/JJD
3	ADDED SCADA RTU	9/30/08	PLM	AJM	
2	"AS CONSTRUCTED" ISSUE	7/28/81	PAM		
1	ISSUED FOR CONSTRUCTION	6/28/80	PAM		



**FOWLERS LANE SUBSTATION No.5**  
LIGHTSHIFT BESS UPGRADES  
IPSWICH ELECTRIC LIGHT DEPT  
IPSWICH, MASSACHUSETTS

SCALE: 1/4" = 1'-0" SIZE: ANSI D

CONTROL BUILDING LAYOUT & DETAILS

DATE:	01/23/26
DRAWN BY:	RDO
ENGINE'D BY:	CEH
PROJECT #:	25337
DRAWING #:	5-E-7-4